

**LANDSCAPING**



HATCH	DESCRIPTION
	WETLAND GRASS SEED WITHIN BMP
	PLANT NO-MOW GRASS SEED ON SLOPES AND ACCESS ROADWAY
	EROSION CONTROL FABRIC ON 2H:1V SLOPES

NOTE: ALL DISTURBED AREAS SHALL BE TEMPORARILY STABILIZED WITH WINTER RYE SEED MIX.

**LEGEND**

LINE STYLE	DESCRIPTION
---	EXISTING 1' CONTOUR
---	EXISTING 5' CONTOUR
W	EXISTING UNDERGROUND WATER
S	EXISTING UNDERGROUND SEWER
G	EXISTING UNDERGROUND GAS
E	EXISTING UNDERGROUND ELECTRIC
OHW	EXISTING OVERHEAD WIRES
D	EXISTING DRAINAGE
X	EXISTING FENCE
---	EXISTING TREELINE
P/L	PROPERTY LINES
---	STREAM/DITCH
BVW	BORDERING VEGETATED WETLANDS
50'	50' BVW BUFFER ZONE
100'	100' BVW BUFFER ZONE
LOW	PROPOSED LIMIT OF WORK
---	PROPOSED CONTOUR
---	LIMITS OF UNDERGROUND GRAVEL
D	PROPOSED SOLID DRAIN LINE, DIAM. >8"
d	PROPOSED SOLID DRAIN LINE, DIAM. <8"
---	PROPOSED PERFORATED DRAIN LINE

	RIPRAP STONE
	INFILTRATION ZONE - WETLAND SOILS SEEDED WITH NEWSPAPER, SEE DETAIL
	PAVEMENT REPLACEMENT

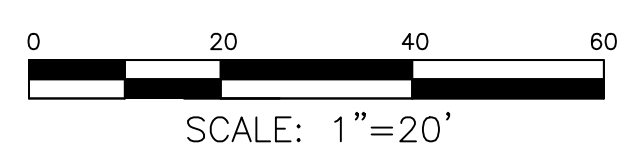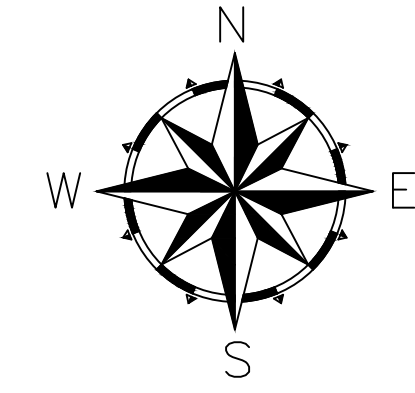

**General Notes**

- THE LOCATION OF UNDERGROUND UTILITIES HAVE NOT BEEN VERIFIED OR INSPECTED. THE CONTRACTOR, PRIOR TO COMMENCEMENT OF CONSTRUCTION, SHALL VERIFY THE LOCATION OF ALL UTILITIES AND CONTACT "DIG-SAFE" AT 1-888-344-7233.
- THE CONTRACTOR SHALL EXERCISE EXTREME CAUTION TO PREVENT ANY DAMAGE TO ADJACENT PROPERTIES. ALL AREAS WHICH ARE AFFECTED BY THE CONTRACTOR'S OPERATIONS SHALL BE RETURNED TO THEIR ORIGINAL CONDITION OR BETTER, AT NO ADDITIONAL COST TO THE OWNER.
- ANY CHANGE IN FIELD CONDITIONS SHALL BE REPORTED TO THE ENGINEER TO INSURE THAT ANY MODIFICATIONS TO THE ORIGINAL DESIGN ARE PROPER AND ADEQUATE TO SERVE THE PROJECT'S NEEDS AND COMPLY WITH THE APPLICABLE STANDARDS AND REGULATIONS.
- CONTRACTOR SHALL IMMEDIATELY REPAIR OR FILL ANY POTHOLES THAT OCCUR DUE TO CONSTRUCTION.
- CONTRACTOR SHALL LINE LIMIT OF WORK (LOW) WITH STRAW BALES STAKED WITH A MINIMUM OF TWO (2) STAKES PER BALE A MINIMUM OF ONE (1) FOOT DEEP INTO THE GROUND.
- REMOVE ALL TEMPORARY EROSION CONTROLS FROM THE SITE AT THE CONCLUSION OF CONSTRUCTION ACTIVITIES.
- CONTRACTOR SHALL REPAIR ALL PAVING ON SITE DAMAGED OR REMOVED DURING CONSTRUCTION.
- STORMWATER SHALL NOT BE DIRECTED INTO THE BASIN UNTIL ALL PLANTINGS ARE SUITABLY ESTABLISHED. CONTRACTOR SHALL EITHER TIE INTO THE EXISTING CATCH BASIN LAST OR INSTALL A REMOVAL PLUG.

7	Landscaping Design As-Built	11/15
6	Landscaping Design	08/15
5	Revised Design for Const.	06/15
4	100% Design for Const.	04/15
3	90% Design	03/15
2	60% Design	02/15
1	Conceptual	01/15
No.	Revision/Issue	Date

**PLANTING SCHEDULE**

KEY	QUANTITY	PLANTING SIZE	NAME	MATURE HEIGHT	NOTES
	5	3'-4'	SWEET PEPPERBUSH ( <i>Clethra alnifolia</i> )	6'-12'	MEDIUM SIZED SHRUB. SWEET SMELLING WHITE FLOWERS IN JULY. PROVIDES FOOD AND COVER FOR BIRDS.
	12	5'-6'	NORTHERN ARROWWOOD ( <i>Viburnum dentatum</i> )	6'-12'	MEDIUM SIZED SHRUB COMMON IN FORESTED WETLANDS. TOLERATES SHADE AND VARIOUS SOILS MIXTURES.
	7	3'-4'	BAYBERRY ( <i>Morella pensylvanica</i> )	10'	MEDIUM SIZED SHRUB WITH PERSISTENT LEAVES THROUGH THE WINTER. WAXY BERRIES PROVIDE FOOD TO SONGBIRDS.
	11	3'-4'	HIGHBUSH BLUEBERRY ( <i>Vaccinium corymbosum</i> )	12'	MEDIUM SIZED SHRUB WITH AROMATIC WHITE FLOWERS. BERRIES HIGHLY VALUED AS WILDLIFE FOOD SOURCE.
	7	2'-3'	VIRGINIA ROSE ( <i>Rosa virginiana</i> )	6'	FAST GROWING SMALLER SHRUB WITH UPRIGHT STEMS. PINK FLOWERS BLOOM IN JUNE. SALT TOLERANT.
	6	2'-3'	BEACH PLUM ( <i>Prunus maritima</i> )	6'-12'	THICKET-FORMING SHRUB OF SANDY COASTAL SITES. FRUIT HIGHLY VALUABLE AS A WILDLIFE FOOD.

OYSTER POND FURLONG - LANDSCAPING AND SURFACE TREATMENTS

**WaterVision, LLC**  
 481 GREAT ROAD, SUITE 3  
 ACTON, MA 01720

**COMPREHENSIVE ENVIRONMENTAL INCORPORATED**  
 21 DEPOT STREET  
 MERRIMACK, NH 03054

EPA Green Infrastructure Education and Outreach Project

OYSTER POND BMP, GRAVEL BIORETENTION CELL

Oyster Pond Furlong and Absegami Run, Chatham, MA

Project No.: 677-2	Sheet
Date: NOVEMBER 2015	
Drawn By: NC	C-5
Checked By: ML	
Horizontal Datum: NAD88	
Vertical Datum: NAVD88	