
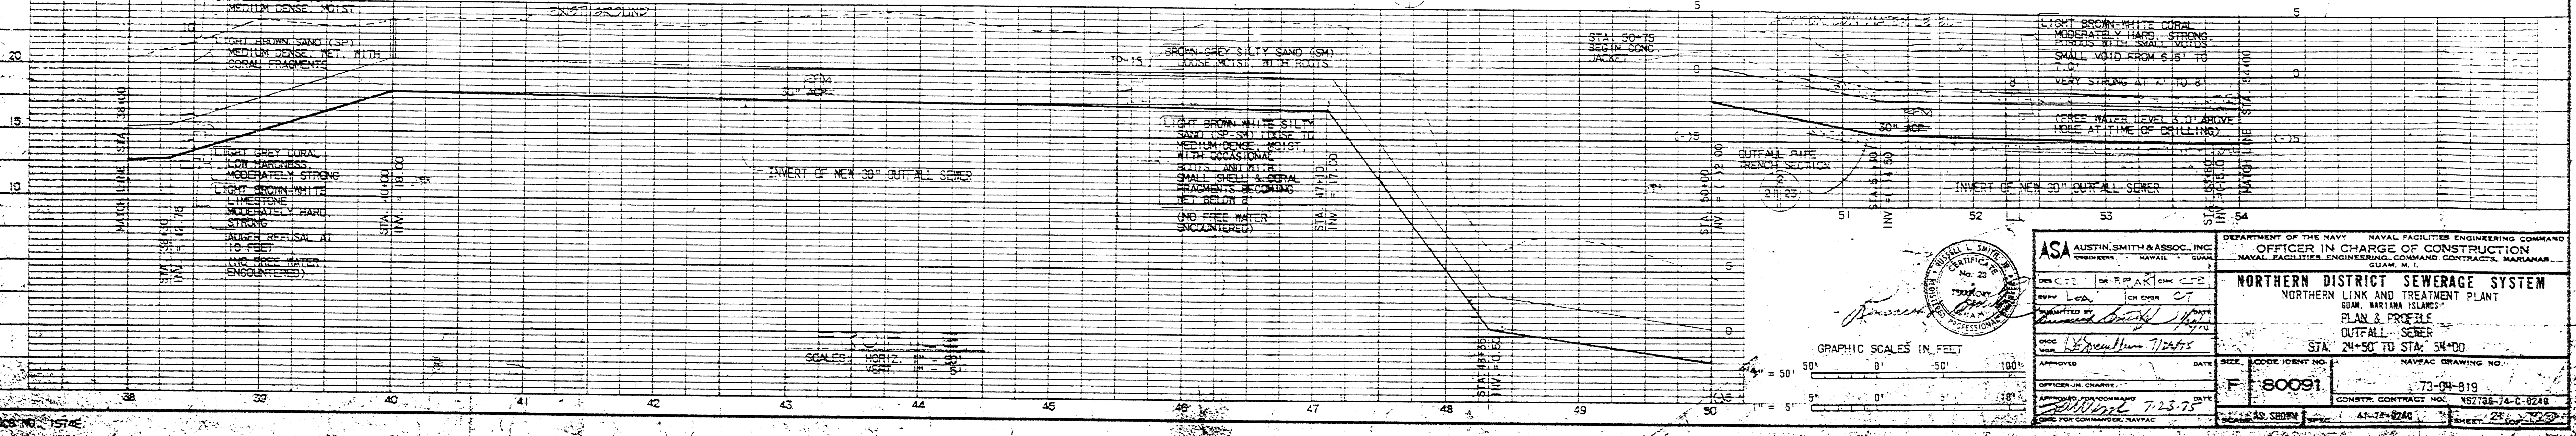
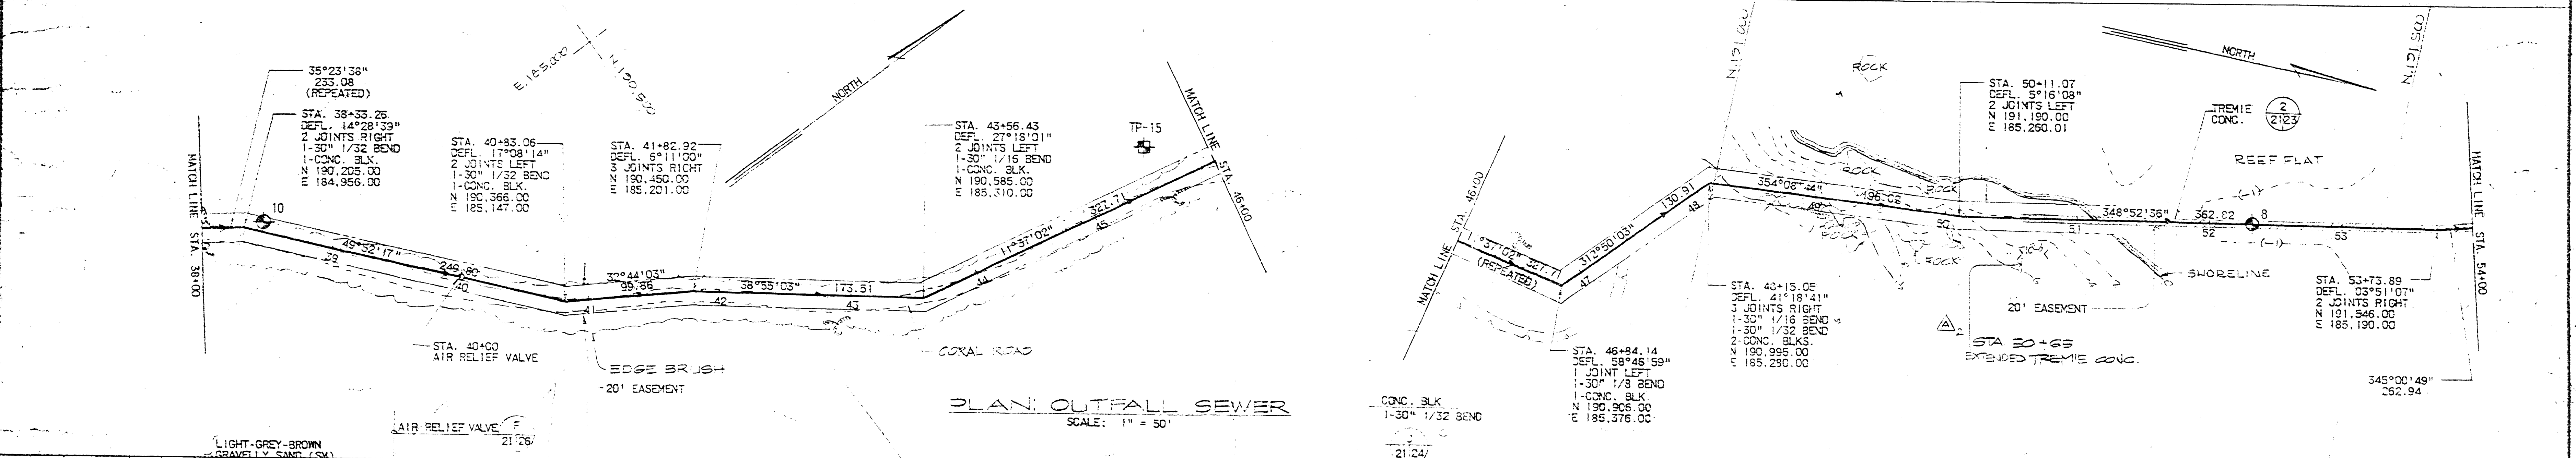


REVISIONS			
NO.	DESCRIPTION	PREP'D BY	DATE
1	REVISED TO SHOW AS BUILT CONDITIONS	LTC/CDR J. F. B.	

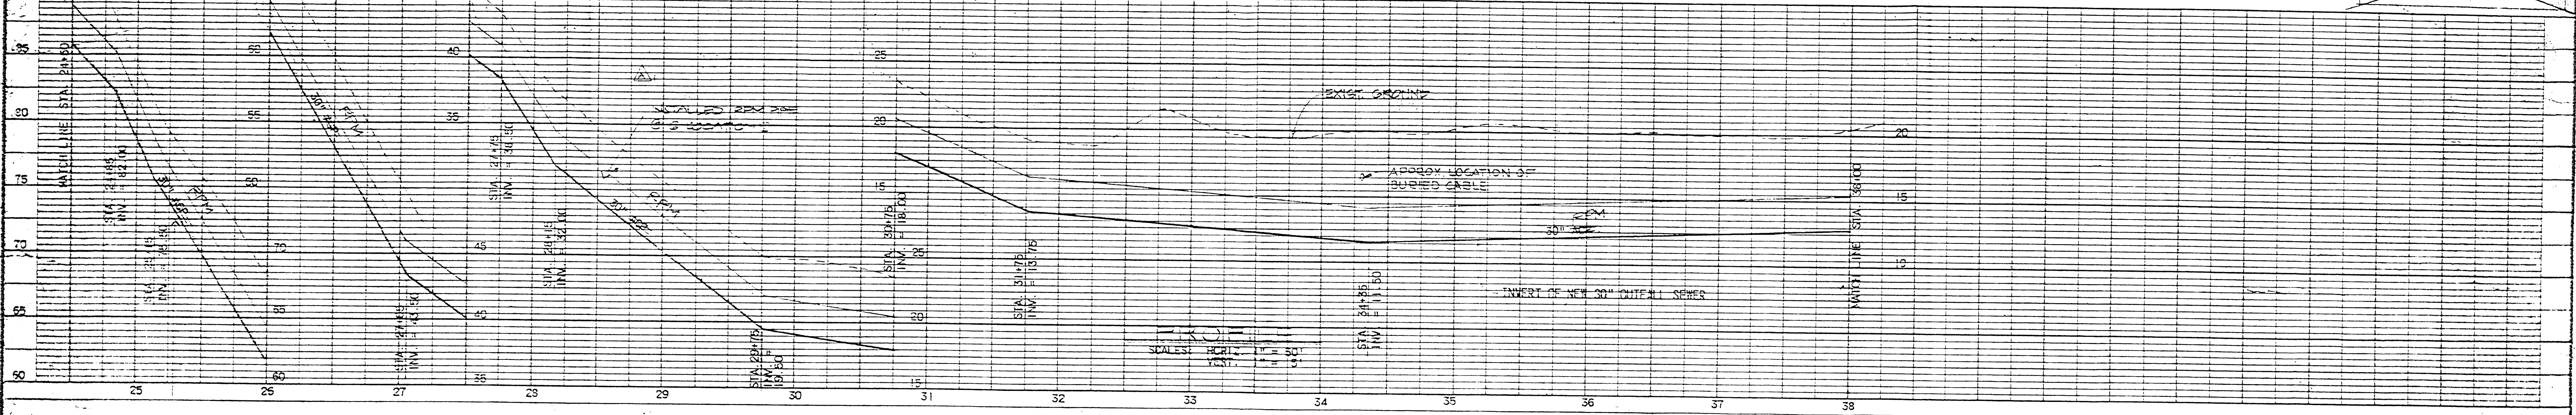

ASA AUSTIN SMITH & ASSOC., INC.  
 DEPARTMENT OF THE NAVY NAVAL FACILITIES ENGINEERING COMMAND  
 OFFICER IN CHARGE OF CONSTRUCTION  
 NAVAL FACILITIES ENGINEERING COMMAND CONTRACTOR, MARAGAN, GUAM, M.I.  
**NORTHERN DISTRICT SEWERAGE SYSTEM**  
 NORTHERN LINK AND TREATMENT PLANT  
 SUB. AREA 14  
 PLAN & PROFILE  
 OUTFALL SEWER  
 STA. 24+00 TO STA. 54+00  
 NAVFAC DRAWING NO. 73-04-819  
 F 80091  
 CONTRACT NO. 15786-74-C-0248  
 SHEET 21 OF 22