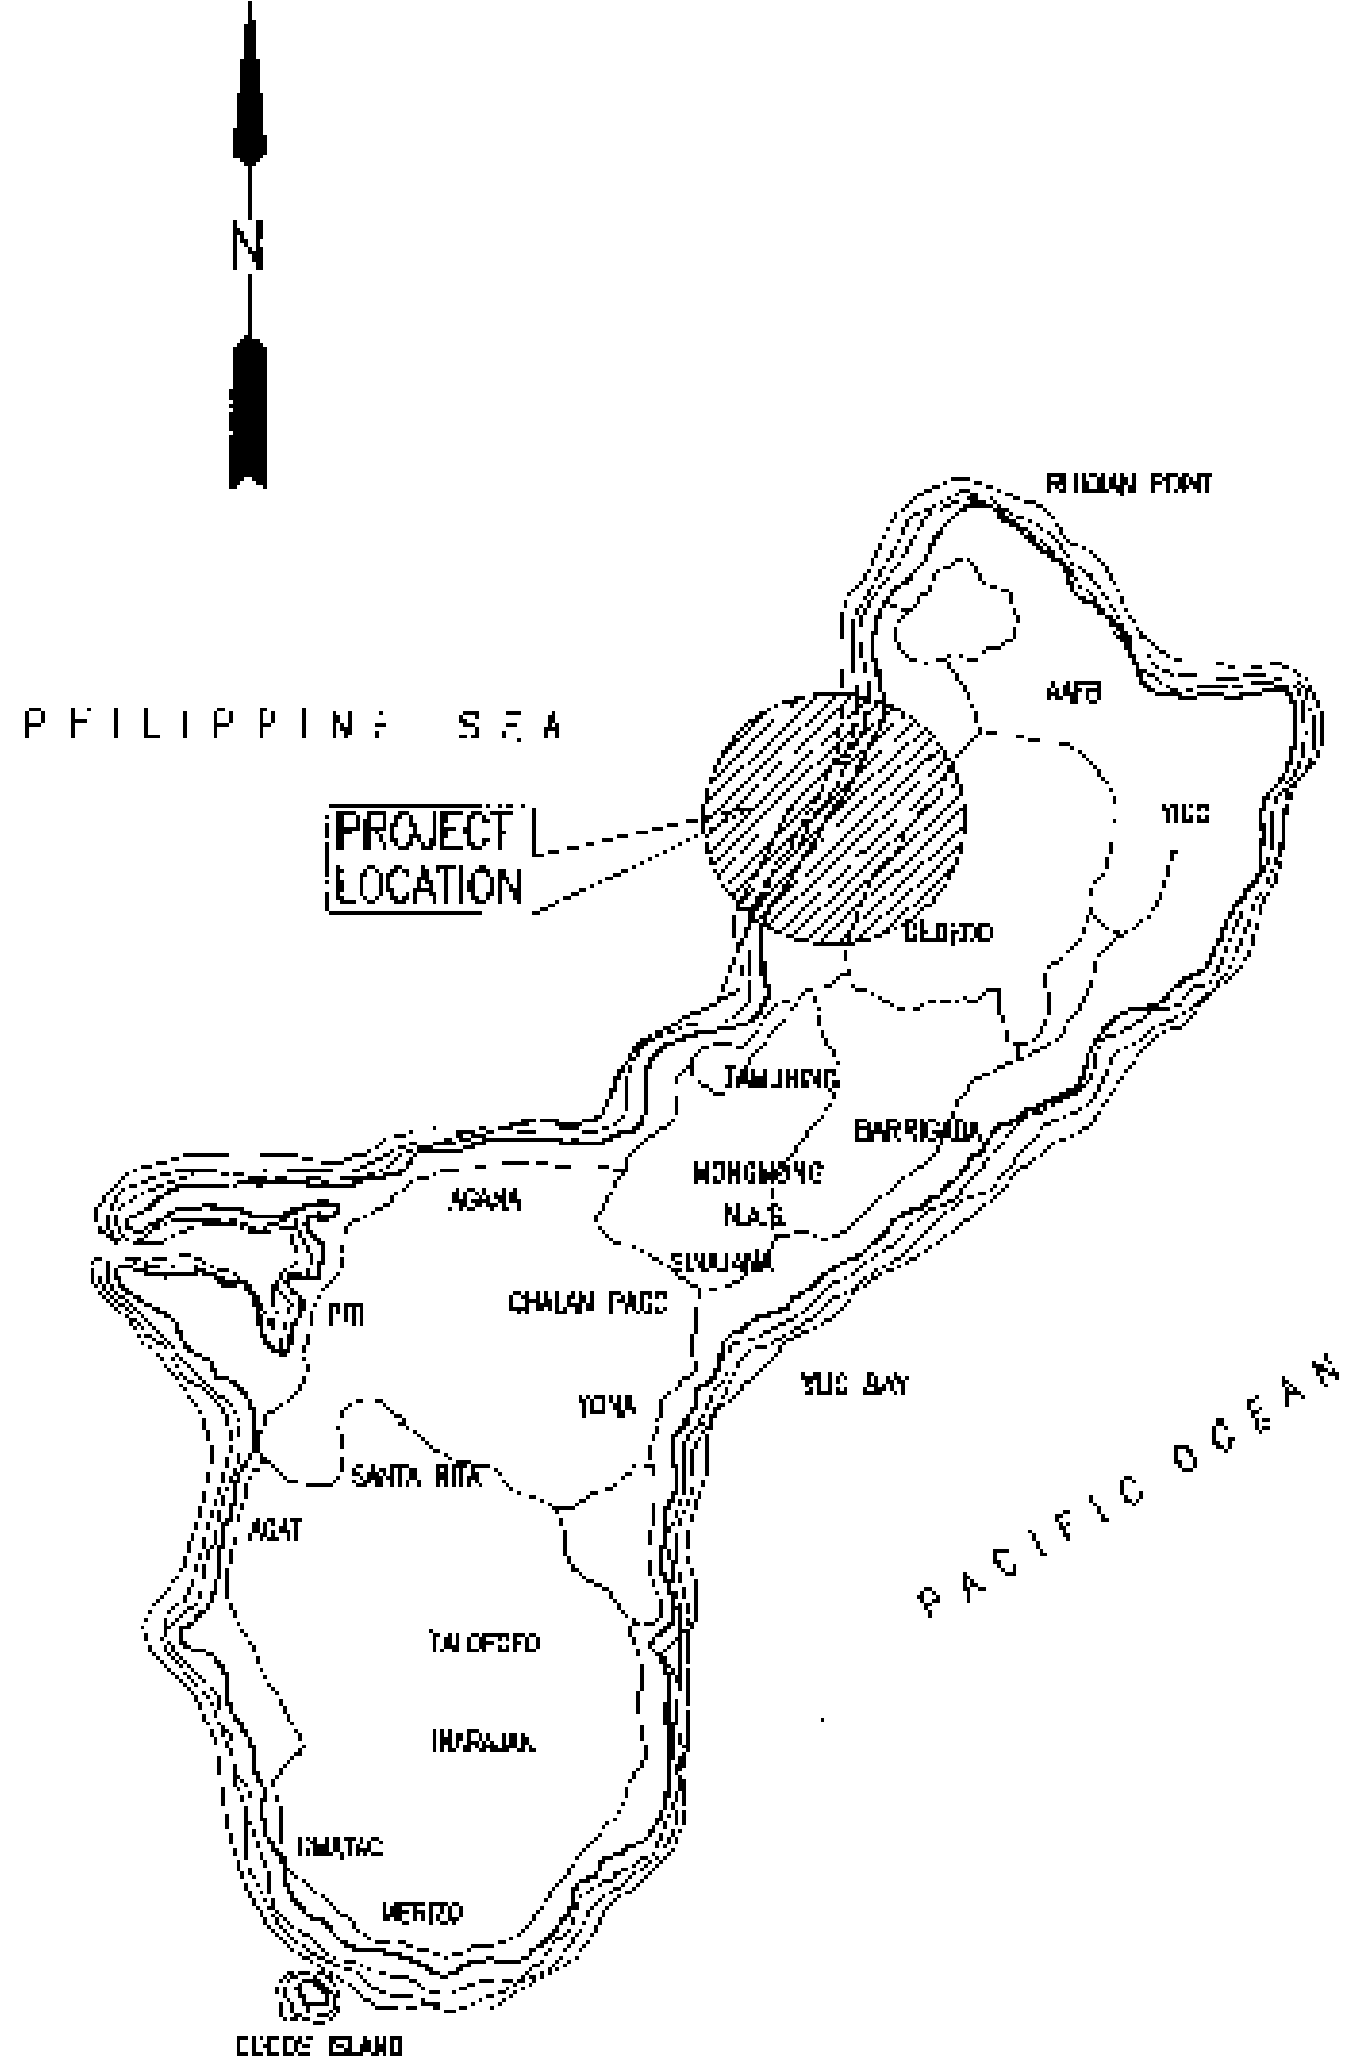
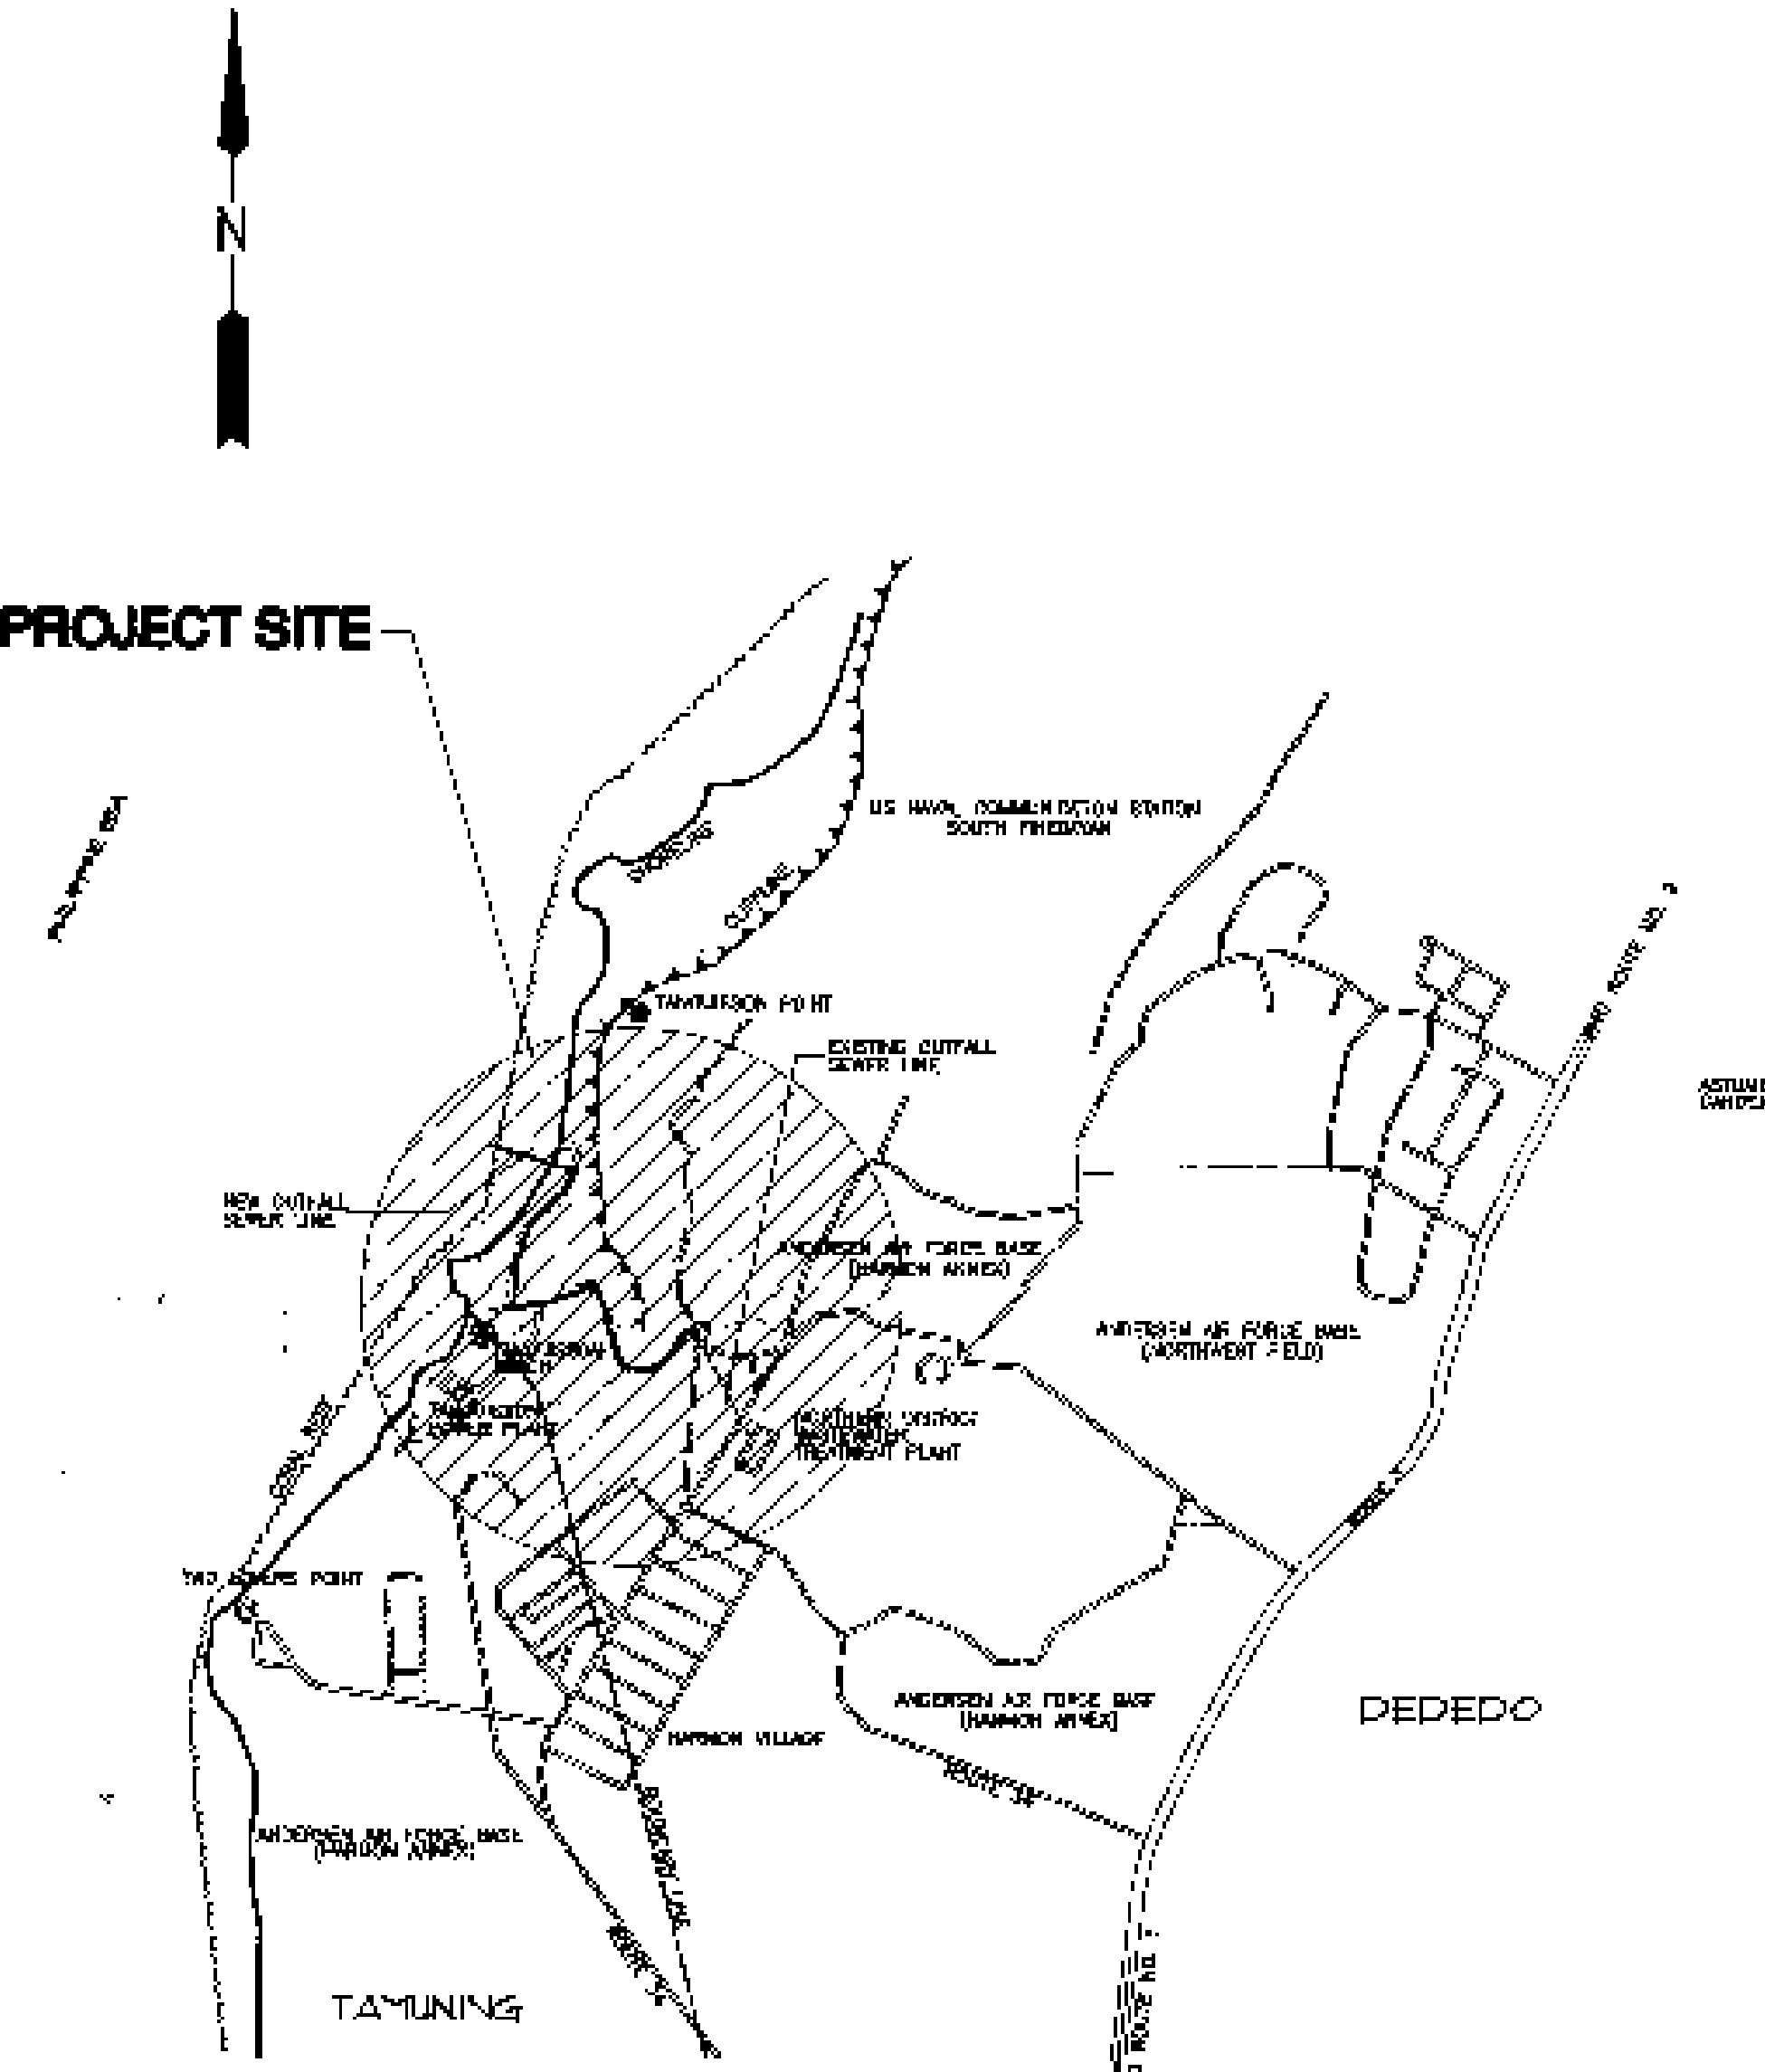


NORTHERN DISTRICT SEWERAGE SYSTEM EFFLUENT FORCE MAIN REPLACEMENT

PROJECT NO. S97 - 001 - LOC

GUAM WATERWORKS AUTHORITY
GOVERNMENT OF GUAM

LOCATION MAP	VICINITY MAP	INDEX OF DRAWINGS	APPROVALS																																														
 <p>PHILIPPINE SEA PACIFIC OCEAN</p>		<table border="1"> <thead> <tr> <th>DRAWING NO.</th> <th>DESCRIPTION</th> <th>SHEET NO.</th> </tr> </thead> <tbody> <tr> <td>TS - 1</td> <td>TITLE SHEET, LOCATION MAP, VICINITY MAP AND INDEX OF DRAWINGS</td> <td>1 OF 11</td> </tr> <tr> <td>LS - 1</td> <td>GENERAL NOTES, ABBREVIATIONS & SYMBOLS</td> <td>2 OF 11</td> </tr> <tr> <td>MP - 1</td> <td>KEY MAP</td> <td>3 OF 11</td> </tr> <tr> <td>C - 1</td> <td>TREATMENT PLANT SITE AS-BUILT & EFFLUENT LINE LAYOUT PLAN</td> <td>4 OF 11</td> </tr> <tr> <td>C - 2</td> <td>PLAN AND PROFILE</td> <td>5 OF 11</td> </tr> <tr> <td>C - 3</td> <td>PLAN AND PROFILE</td> <td>6 OF 11</td> </tr> <tr> <td>C - 4</td> <td>PLAN AND PROFILE</td> <td>7 OF 11</td> </tr> <tr> <td>C - 5</td> <td>PLAN AND PROFILE</td> <td>8 OF 11</td> </tr> <tr> <td>C - 6</td> <td>BORING LOGS</td> <td>9 OF 11</td> </tr> <tr> <td>D - 1</td> <td>DETAILS</td> <td>10 OF 11</td> </tr> <tr> <td>D - 2</td> <td>DETAILS</td> <td>11 OF 11</td> </tr> </tbody> </table> <p>SUMITOMO CONSTRUCTION CO. LTD AS-BUILT DRAWING</p> <p>This certifies that the dimensions and details shown on this sheet reflect the conditions and details as constructed in the field.</p> <p><i>[Signature]</i> Date: _____</p>	DRAWING NO.	DESCRIPTION	SHEET NO.	TS - 1	TITLE SHEET, LOCATION MAP, VICINITY MAP AND INDEX OF DRAWINGS	1 OF 11	LS - 1	GENERAL NOTES, ABBREVIATIONS & SYMBOLS	2 OF 11	MP - 1	KEY MAP	3 OF 11	C - 1	TREATMENT PLANT SITE AS-BUILT & EFFLUENT LINE LAYOUT PLAN	4 OF 11	C - 2	PLAN AND PROFILE	5 OF 11	C - 3	PLAN AND PROFILE	6 OF 11	C - 4	PLAN AND PROFILE	7 OF 11	C - 5	PLAN AND PROFILE	8 OF 11	C - 6	BORING LOGS	9 OF 11	D - 1	DETAILS	10 OF 11	D - 2	DETAILS	11 OF 11	<p><i>[Signature]</i> RICHARD A. QUINTANILLA GENERAL MANAGER GUAM WATERWORKS AUTHORITY</p> <p><i>[Signature]</i> JESUS T. SALAS ADMINISTRATOR GUAM ENVIRONMENTAL PROTECTION AGENCY</p> <p><i>[Signature]</i> ANTHONY F. QUINATA, P.E. ENGINEER DEPARTMENT OF PUBLIC WORKS</p> <table border="1"> <thead> <tr> <th>REV.</th> <th>DATE</th> <th>BY</th> <th>DESCRIPTION</th> <th>APPROVED</th> </tr> </thead> <tbody> <tr> <td> </td> <td> </td> <td> </td> <td> </td> <td> </td> </tr> </tbody> </table> <p>PACIFIC ISLAND ENGINEERS CONSULTANTS P.O. BOX 4092, TAMPUNING, GUAM 96931 TEL. NO. 465-7431/2 FAX NO. 465-1082</p> <p>DES. P.I.E. DRN. C.E.C. CHK. JAC/J.E.Y. SUBMITTED BY: <i>[Signature]</i> DATE: APRIL 87</p> <p>RECOMMENDED BY: <i>[Signature]</i> DATE: _____ JOB ORDER NO. _____ PROJECT ENGINEER: VINCELO NICOLAS PROJECT CHIEF: QUINCY H. BARRAS, P.E. PROJECT MANAGER: BENATO ALICAZAREN</p> <p>SCALE: PWAG DWG. NO. _____ SHT. 1 OF 11</p>	REV.	DATE	BY	DESCRIPTION	APPROVED					
DRAWING NO.	DESCRIPTION	SHEET NO.																																															
TS - 1	TITLE SHEET, LOCATION MAP, VICINITY MAP AND INDEX OF DRAWINGS	1 OF 11																																															
LS - 1	GENERAL NOTES, ABBREVIATIONS & SYMBOLS	2 OF 11																																															
MP - 1	KEY MAP	3 OF 11																																															
C - 1	TREATMENT PLANT SITE AS-BUILT & EFFLUENT LINE LAYOUT PLAN	4 OF 11																																															
C - 2	PLAN AND PROFILE	5 OF 11																																															
C - 3	PLAN AND PROFILE	6 OF 11																																															
C - 4	PLAN AND PROFILE	7 OF 11																																															
C - 5	PLAN AND PROFILE	8 OF 11																																															
C - 6	BORING LOGS	9 OF 11																																															
D - 1	DETAILS	10 OF 11																																															
D - 2	DETAILS	11 OF 11																																															
REV.	DATE	BY	DESCRIPTION	APPROVED																																													