



1
MP
KEY MAP

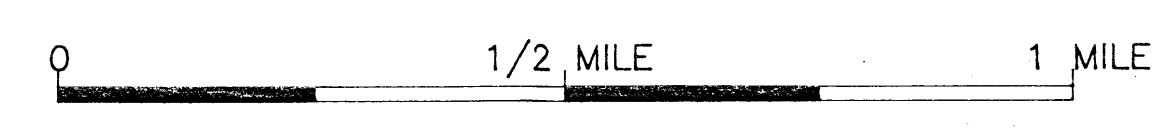

SUMITOMO CONSTRUCTION CO. LTD
AS-BUILT DRAWING
This certifies that the dimensions and details shown on this sheet reflect the dimension and details as constructed in the field.
Signature: *[Signature]* Date: *[Date]*

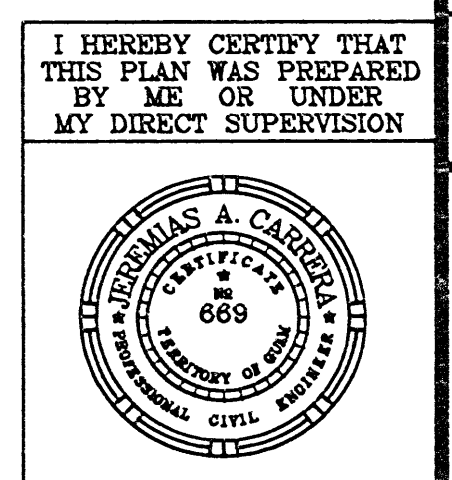

REV.	DATE	BY	DESCRIPTION	APPROVED
			GOVERNMENT OF GUAM GUAM WATERWORKS AUTHORITY	
DES. P.I.E.	DRN. CEC	CHK. JAC/FEY	NORTHERN DISTRICT SEWERAGE SYSTEM EFFLUENT FORCE MAIN REPLACEMENT	
SUPV. JAC	DATE	APRIL 97		
SUBMITTED BY:			KEY MAP	
I HEREBY CERTIFY THAT THIS PLAN WAS PREPARED BY ME OR UNDER MY DIRECT SUPERVISION 				
VIRGILIO NICOLAS PROJECT ENGINEER		RECOMMENDED BY: DATE JOB ORDER NO. QUIRINO H. BASBAS, P.E. CHIEF ENGINEER		DRAWING NO. MP - 1
RENATO ALCAZAREN PROJECT MANAGER		SCALE: PUAG DWG. NO.		SHT. 3 OF 11